




**EXISTING TYPICAL WIDE SECTION OF CANAL** ①  
 SCALE: 1"=4'-0"  
 STA. 0+10 TO STA. 1+70  
 STA. 7+35 TO STA. 15+90  
 STA. 19+81 TO STA. 20+88  
 STA. 25+85 TO STA. 27+43

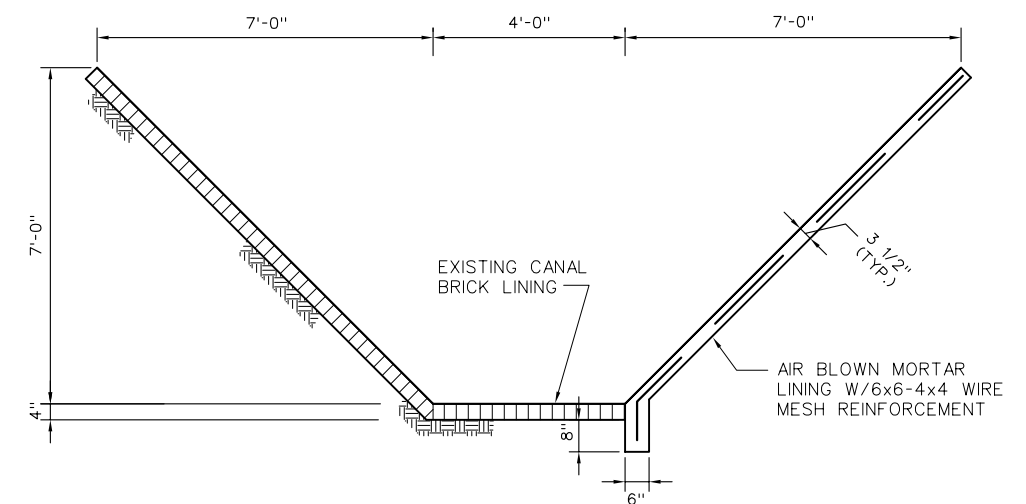

**EXISTING TYPICAL NARROW SECTION OF CANAL** ②  
 SCALE: 1"=4'-0"  
 STA. 1+70 TO STA. 7+35  
 STA. 15+90 TO STA. 19+81  
 STA. 20+88 TO STA. 25+85  
 STA. 27+43 TO STA. 35+60

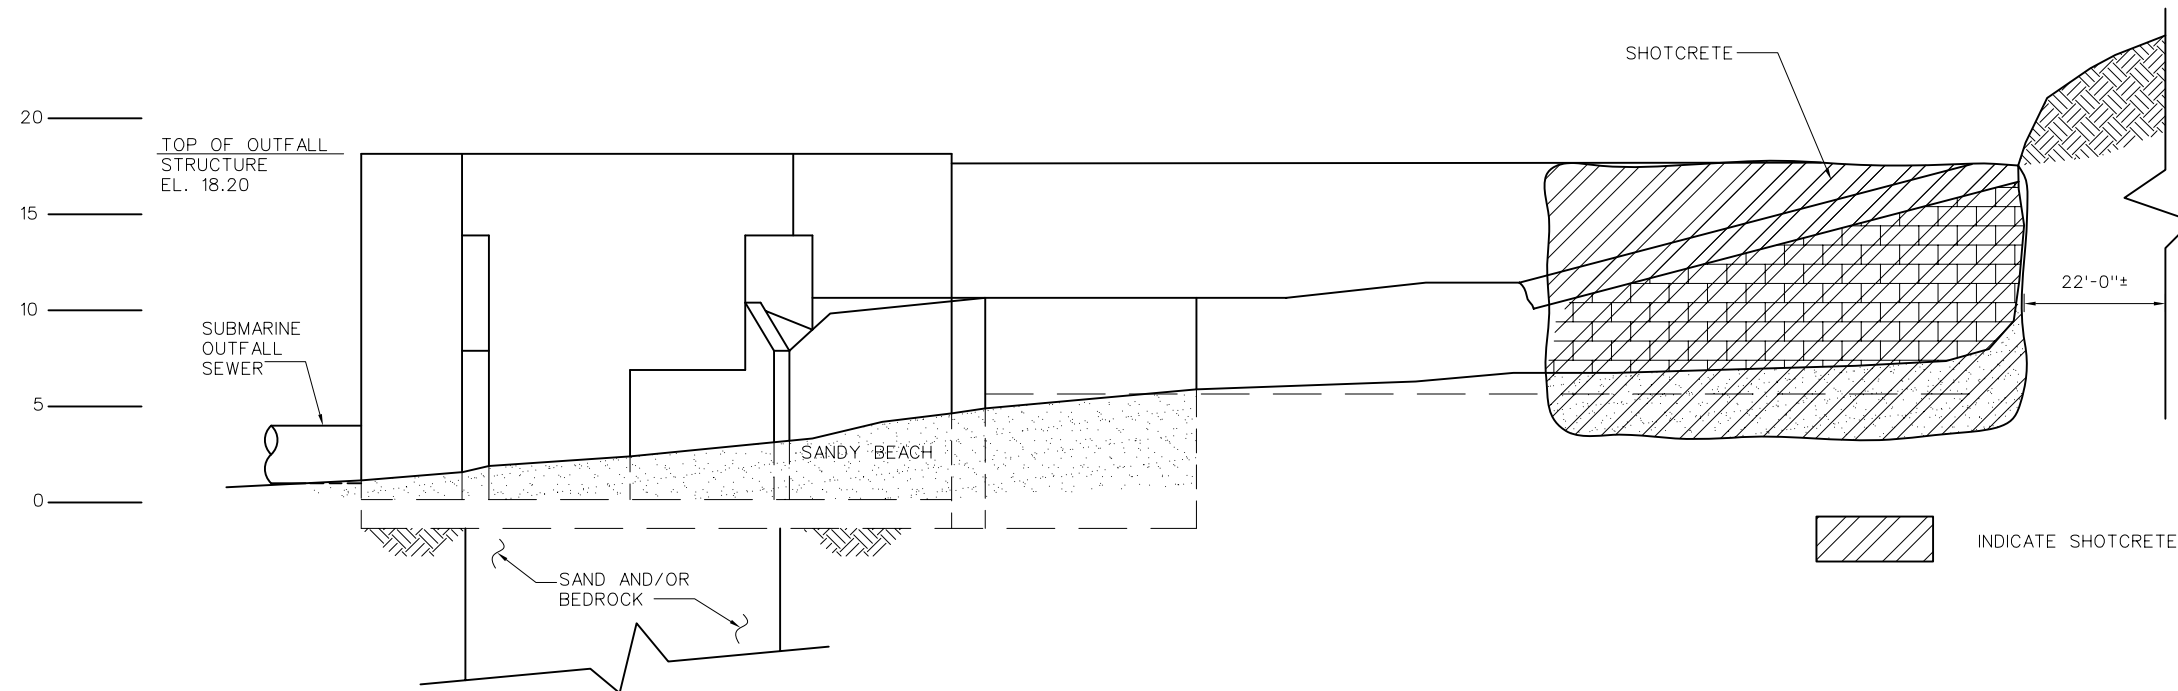

**SOUTH ELEVATION OF EXISTING DALY CITY OUTFALL STRUCTURE** ③  
 SCALE: 1"=10'-0"

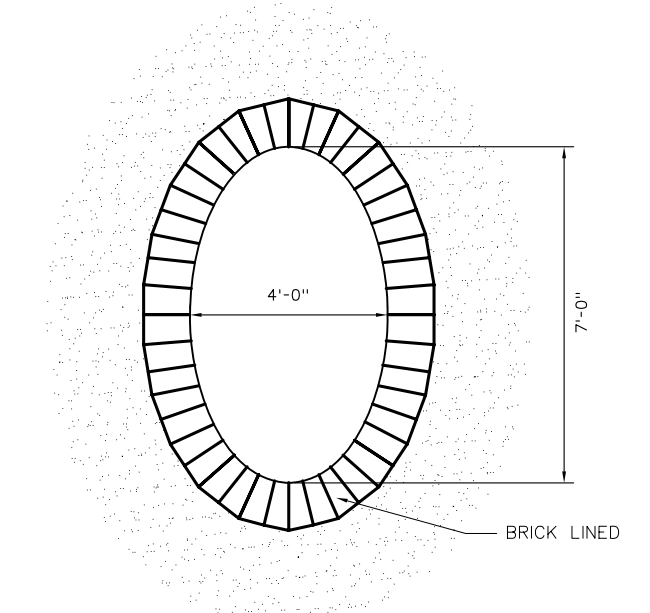

**EXISTING SECTION OF VISTA GRANDE TUNNEL** ④  
 SCALE: 1/2"=1'-0"

**NOTES:**

- ELEVATIONS OF OUTFALL REFERENCE NGVD 1929 DATUM.
- FOR REFERENCE ONLY. REFER TO THE CITY OF DALY CITY-VISTA GRANDE STORM SEWER CANAL WIDENING AND REPAIR AUGUST 1973 DWG. C 73-E-22 FOR FULL DETAILS.

**JACOBS ASSOCIATES**  
 Engineers/Consultants

**THE CITY OF DALY CITY**  
 CALIFORNIA  
 DEPARTMENT OF PUBLIC WORKS  
**VISTA GRANDE DRAINAGE**  
**BASIN TUNNEL ANALYSIS**  
  
**FIGURE A.2**  
**EXISTING FACILITIES &**  
**AS-BUILT DESIGNS**

DRAWN EGB	DATE 10/2007		
CHECKED RHS	SCALE AS SHOWN		
DESIGNED ESH			0 REV.